PDF-XChange Editor Click to BUY NOW! www.pdf-xchange.com

HYDE PARK DEVELOPMENTS

mimar

EGY SMART FOR MODERN ENGINEERING

Hyde Park North Project

Submittal Transmittal No.	Rev.
SS-CP48-SD-ARCH-0025	0

SUBMITTAL TRANSMITTAL

Date: 2026-05-19

TRANSMISSION OF DRAWINGS, DOCUMENTS, MATERIALS, ETC.

Contract Name : Remaining finishes work -part A

Contract No.:SS-CP48

From: Egysmart for modern engineering

To: Mimar Egypt Engineering Consultants

TOWN HOUSE - 71- 73-74-75

SUBMITTED FOR	CODE
APPROVAL	1
YOUR INFORMATION	2
OTHERS	3
ACTION	
APPROVED	A
APPROVED AS NOTED	B
REVISE AND RESUBMIT	C
REJECTED	D
FOR INFORMATION	E

WE ARE SENDING HEREWITH / UNDER SEPARATE COVER, THE DRAWINGS/ DOCUMENTS / SAMPLES LISTED BELOW. (DELETE AS NECESSARY)

No	Size	Rev	Document Type	Copies	DESCRIPTION	+ TYPE	CODE
1	A0	0	SD	2			
SS-CP48-TOWN-HOUSE-SD-ARCH-051					Wet areas ceramic tiles for ground floor	SD	B
SS-CP48-TOWN-HOUSE-SD-ARCH-052					Wet areas ceramic tiles for first floor	SD	C

FOR CONTRACTOR DATE: 6/7/0/19

Engineer to enter Action Codes and Remarks, and return to Contractor

REMARKS :

ENGINEER'S COMMENTS

Code C

* Refer to Comment on drawing.

EGYSMART FOR MODERN ENGINEERING RECEIVED 4/8/2026

mimar Architecture & Engineering www.mimararchitecture.com REGISTERED PROFESSIONAL ENGINEER SIGNATURE DATE

COPIES TO

FOR ENGINEER DATE: 3/8/2026

EMPLOYER 'S COMMENTS (IF REQUIRED)

JR


Received 20 MAY 2026 mimar

COPIES TO


FOR EMPLOYER DATE:

Corrections or comments made relative to submittals during this review do not relieve the contractor from compliance with the requirements of the drawings and specifications. This check is only for review of general conformance with the design concept of the project and general compliance with the information given in the contract documents. The contractor is responsible for confirming and correlating all quantities and dimensions selecting fabrication processes and techniques of construction; coordinating his work with that of other trades, and performing his work in a safe and satisfactory manner.


TYPE : SD:Shop Drawing CA:Calculation SM:Sample MS:Method Statement GT:Guarantee TF:Temporary Facilities OT:Other CT:Certificates TT:Test Results MK:Mock-up MD:Manufacturer's Data

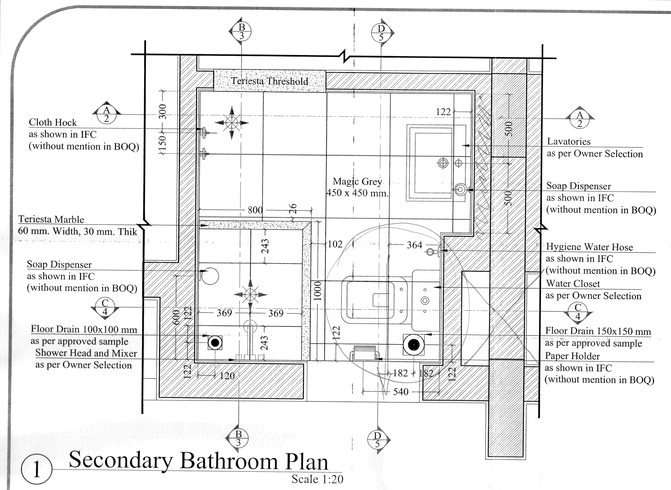


1 Secondary Bathroom Plan
Scale 1:20

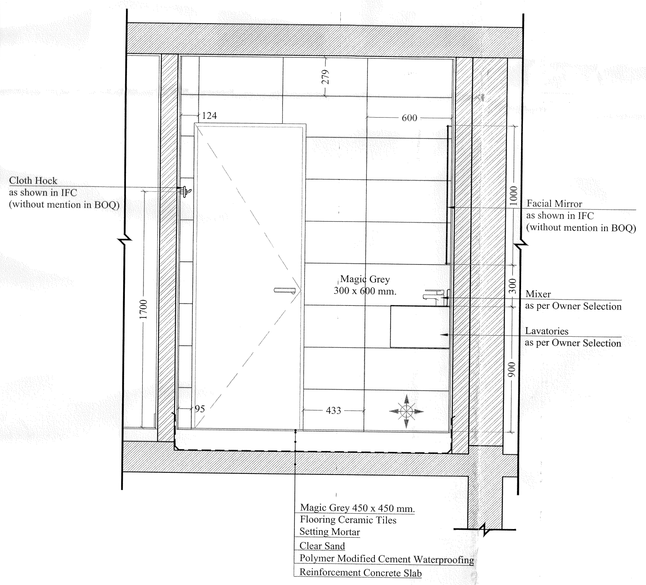


2 Sec. A-A
Scale 1:20

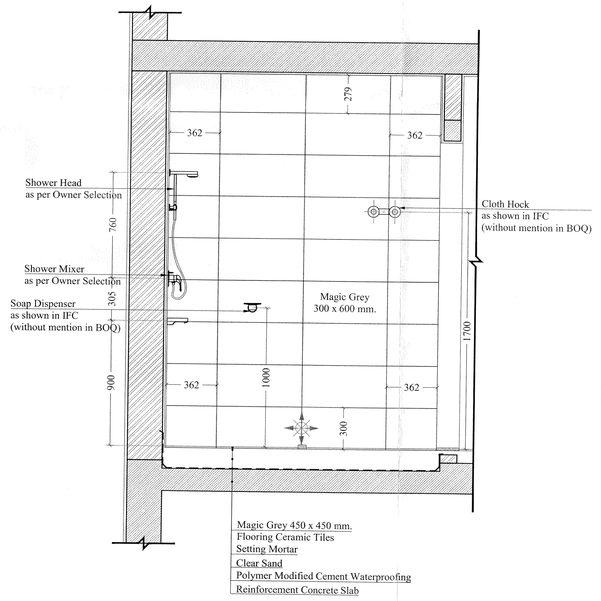


3 Sec. B-B
Scale 1:20

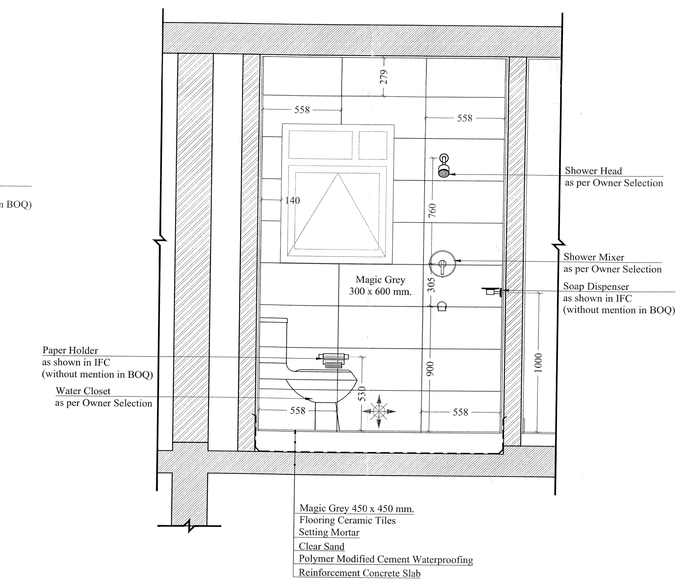


4 Sec. C-C
Scale 1:20

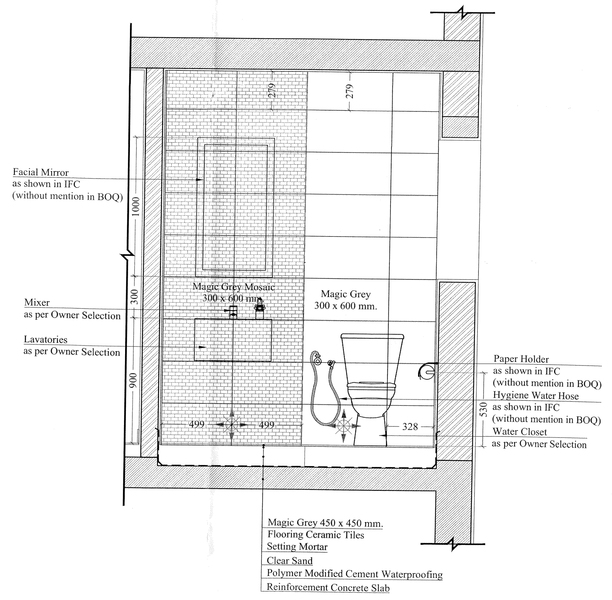


5 Sec. D-D
Scale 1:20

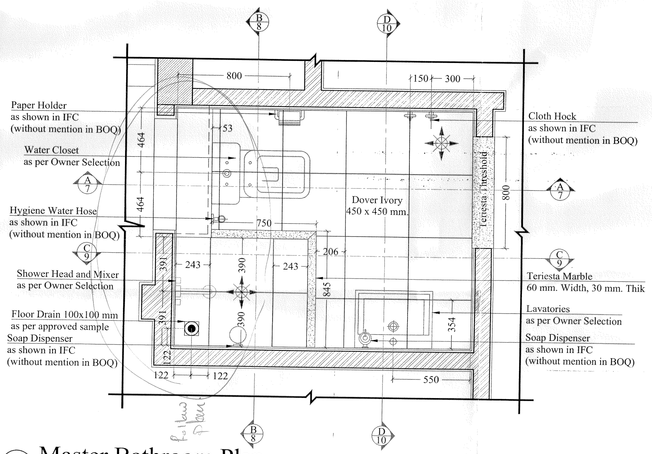


6 Master Bathroom Plan
Scale 1:20

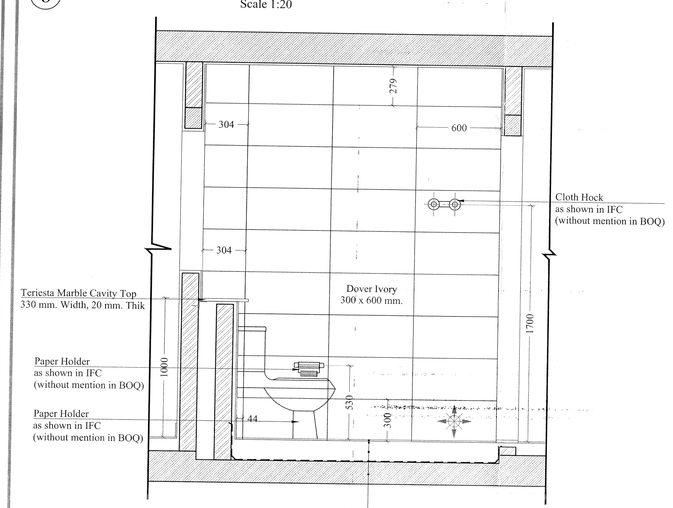


7 Sec. A-A
Scale 1:20

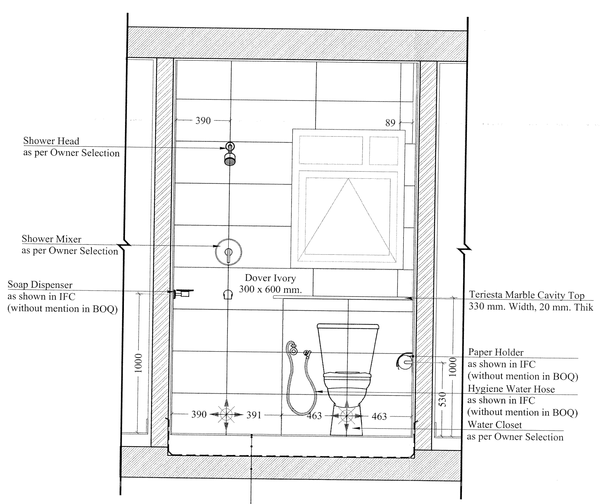

8 Sec. B-B
Scale 1:20

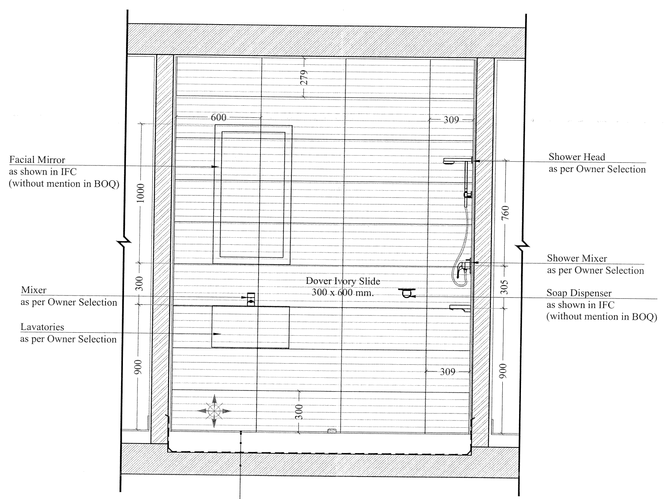

9 Sec. C-C
Scale 1:20

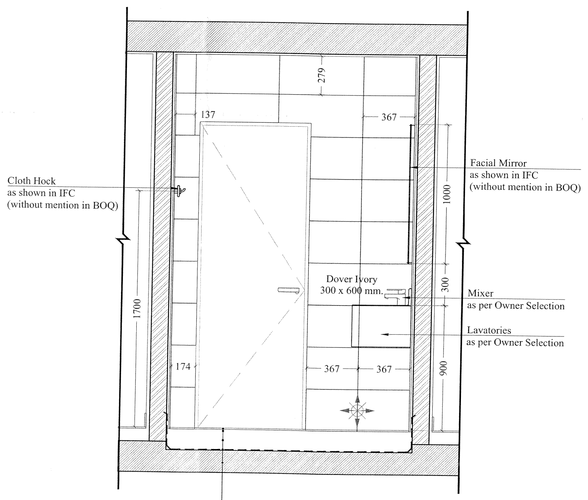


10 Sec. D-D
Scale 1:20

GENERAL NOTES

- ALL DIMENSIONS SHOULD BE VERIFIED ON SITE AND APPROVED BY THE AUTHORIZED ENGINEER.
- UNLESS OTHERWISE INDICATED, DIMENSIONS ARE IN MILLIMETERS AND ANGLES ARE IN DEGREES.
- DRAWINGS ARE NOT TO BE SCALED, WRITTEN DIMENSIONS SHOULD BE FOLLOWED.
- ALL DRAWINGS SHOULD BE READ IN CONJUNCTION WITH OTHER RELEVANT ARCHITECTURAL, STRUCTURAL, MECHANICAL, ELECTRICAL DRAWINGS AND ALL OTHER RELEVANT SECTIONS OF SPECIFICATIONS.
- FOR SYMBOLS & ABBREVIATIONS, REFER TO DRAWING A1002.
- FOR STRUCTURE ELEMENTS AND STRUCTURE ELEMENTS SUPPORTING MASONRY WORKS REFER TO STRUCTURAL DRAWINGS.
- UNLESS OTHERWISE INDICATED, ALL THE STRUCTURE ELEMENTS SUPPORTING MASONRY WALLS SHOULD BE WITHIN WALLS THICKNESS.
- FOR EXTERNAL LEVELS, SLOPES, FINISHES, DIMENSIONS, ETC...., REFER TO LANDSCAPE & ROADS DRAWINGS.
- FOR DOORS, WINDOWS AND ELEVATION TYPES' LOCATION AND DIMENSIONS REFER TO OPENINGS TYPE SHEETS AND SCHEDULES.
- JUNCTIONS BETWEEN REINFORCED CONCRETE AND BLOCK WORKS SHOULD BE TREATED BY METAL LATH PRIOR TO APPLYING PLASTER.
- ALL KITCHEN AND TOILETS WALLS SHOULD BE OF SOLID MASONRY UNITS.
- UNLESS OTHERWISE INDICATED ON DRAWINGS, DOOR JAMBS SHOULD BE LOCATED 200MM FROM THE NEAREST ADJACENT WALL FACE.
- FOR EXACT LOCATION AND SIZE OF MEP OPENINGS, REFER TO STRUCTURAL DRAWINGS. SHOP DRAWINGS FOR THE COORDINATED OPENINGS SHOULD BE SUBMITTED TO THE AUTHORIZED ENGINEER FOR APPROVAL.
- ALL WALL SHOULDERS BEHIND ALL DOORS ARE EQUAL 120MM
- ALL MECH. SHAFTS ARE ACCESSIBLE BY ACCESS PANEL IN THE TOILETS AS PER STANDARD DETAIL NO. DA-0108-A

KEY PLAN

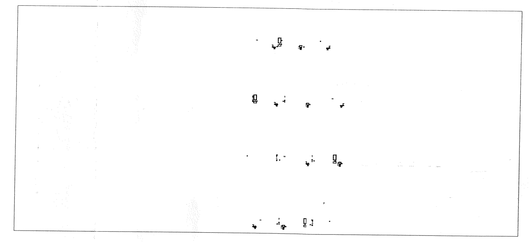

Project
HYDE PARK NORTH PROJECT


Owner
HYDE PARK
FOR DEVELOPMENT

Project Consultant
mimar


Main Contractor
EGY SMART
FOR MODERN ENGINEERING

Drawing Title :
Wet Areas Ceramic Tiles
First Floor


Drawn By.	ENG.Ahmed Yassin	Building Type	Scale		
Approved BY.	ENG.Ahmed Yassin	Town house	Document Type	Shopdrawing	
Drawing No.	SS-CP48-TOWN HOUSE-SD-ARCH-052	Date	May 2026	Floor Level	TYP.

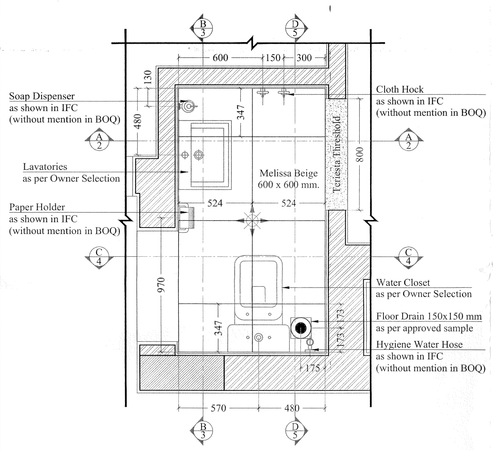


1 Guest Toilet Plan
Scale 1:20

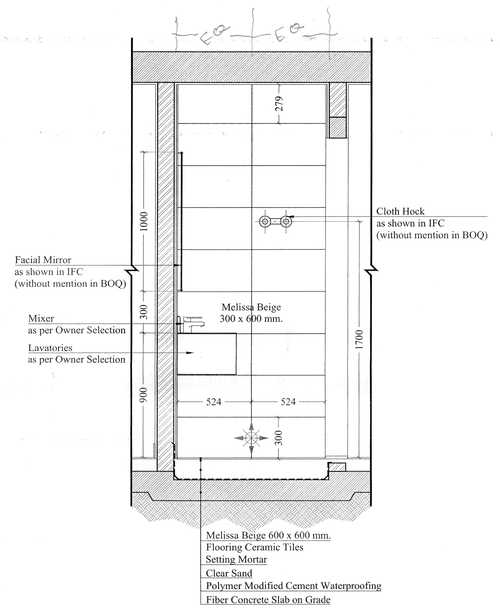


2 Sec. A-A
Scale 1:20

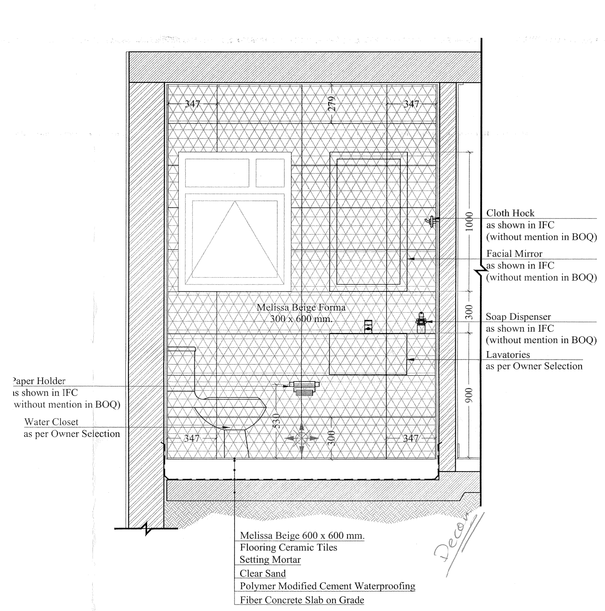


3 Sec. B-B
Scale 1:20

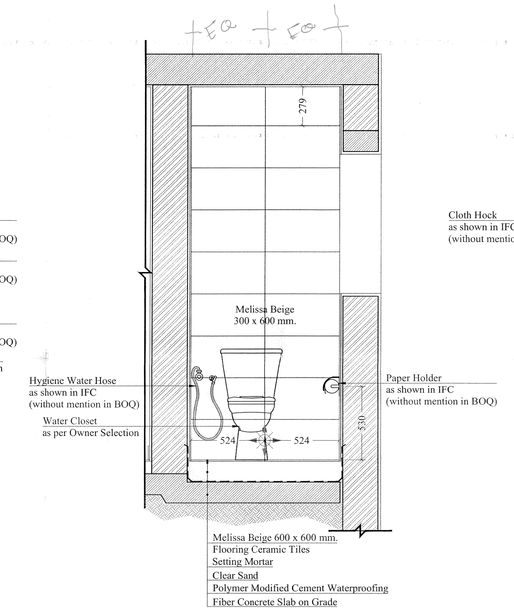


4 Sec. C-C
Scale 1:20

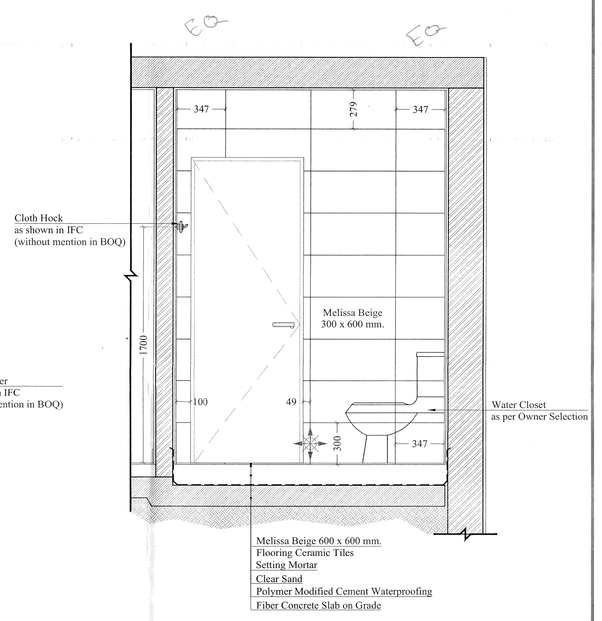


5 Sec. D-D
Scale 1:20

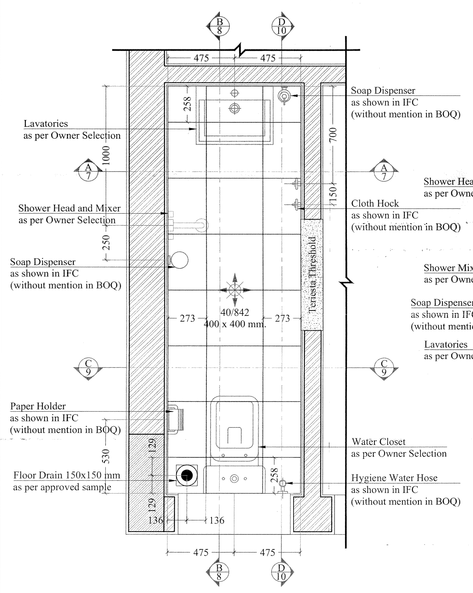


6 Maid Bathroom Plan
Scale 1:20

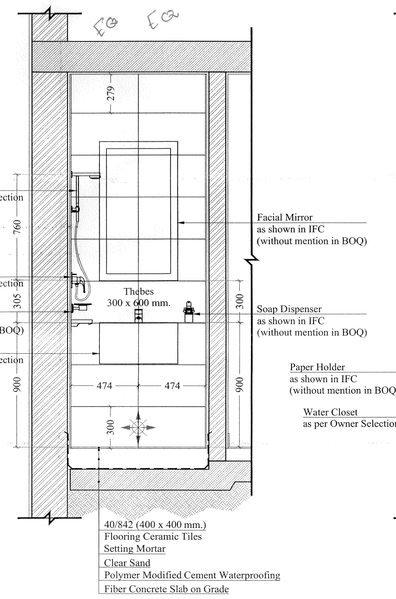


7 Sec. A-A
Scale 1:20

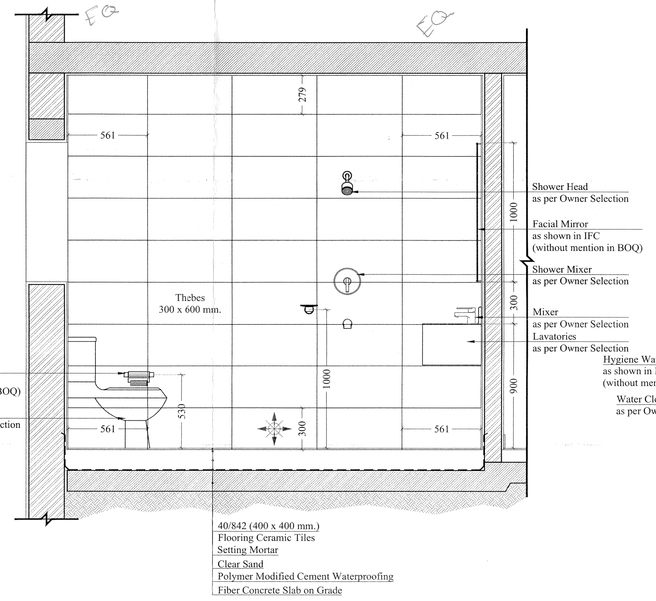


8 Sec. B-B
Scale 1:20

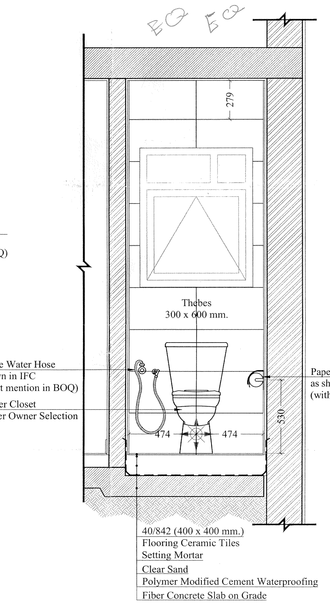


9 Sec. C-C
Scale 1:20

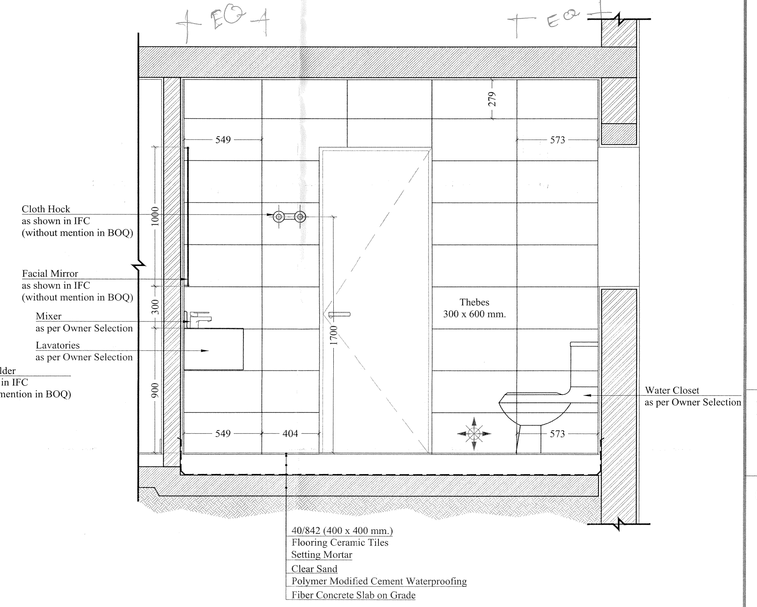


10 Sec. D-D
Scale 1:20

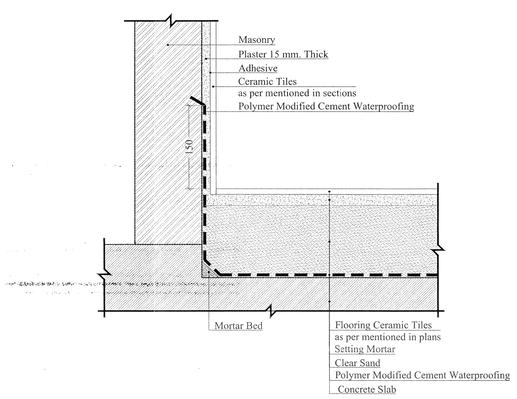

11 Flooring Layers Typical Detail
Scale 1:5

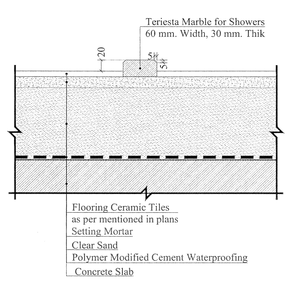

12 Showers Typical Detail
Scale 1:5

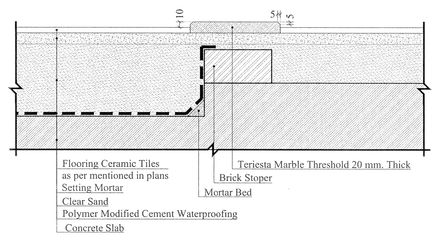

13 Marble Threshold Typical Detail
Scale 1:5

GENERAL NOTES

- ALL DIMENSIONS SHOULD BE VERIFIED ON SITE AND APPROVED BY THE AUTHORIZED ENGINEER.
- UNLESS OTHERWISE INDICATED, DIMENSIONS ARE IN MILLIMETERS AND ANGLES ARE IN DEGREES.
- DRAWINGS ARE NOT TO BE SCALED, WRITTEN DIMENSIONS SHOULD BE FOLLOWED.
- ALL DRAWINGS SHOULD BE READ IN CONJUNCTION WITH OTHER RELEVANT ARCHITECTURAL, STRUCTURAL, MECHANICAL, ELECTRICAL DRAWINGS AND ALL OTHER RELEVANT SECTIONS OF SPECIFICATIONS.
- FOR SYMBOLS & ABBREVIATIONS, REFER TO DRAWING AI002.
- FOR STRUCTURE ELEMENTS AND STRUCTURE ELEMENTS SUPPORTING MASONRY WORKS REFER TO STRUCTURAL DRAWINGS.
- UNLESS OTHERWISE INDICATED, ALL THE STRUCTURE ELEMENTS SUPPORTING MASONRY WALLS SHOULD BE WITHIN WALLS THICKNESS.
- FOR EXTERNAL LEVELS, SLOPES, FINISHES, DIMENSIONS, ETC...., REFER TO LANDSCAPE & ROADS DRAWINGS.
- FOR DOORS, WINDOWS AND ELEVATION TYPES' LOCATION AND DIMENSIONS REFER TO OPENINGS TYPE SHEETS AND SCHEDULES.
- JUNCTIONS BETWEEN REINFORCED CONCRETE AND BLOCK WORKS SHOULD BE TREATED BY METAL LATH PRIOR TO APPLYING PLASTER.
- ALL KITCHEN AND TOILETS WALLS SHOULD BE OF SOLID MASONRY UNITS.
- UNLESS OTHERWISE INDICATED ON DRAWINGS, DOOR JAMBS SHOULD BE LOCATED 200MM FROM THE NEAREST ADJACENT WALL FACE.
- FOR EXACT LOCATION AND SIZE OF MEP OPENINGS, REFER TO STRUCTURAL DRAWINGS, SHOP DRAWINGS FOR THE COORDINATED OPENINGS SHOULD BE SUBMITTED TO THE AUTHORIZED ENGINEER FOR APPROVAL.
- ALL WALL SHOULDERS BEHIND ALL DOORS ARE EQUAL 120MM
- ALL MECH. SHAFTS ARE ACCESSIBLE BY ACCESS PANEL IN THE TOILETS AS PER STANDARD DETAIL NO. DA-D108-A

Project
HYDE PARK NORTH PROJECT

Owner
HYDE PARK
FOR DEVELOPMENT

Project Consultant
mimar

Main Contractor
EGY SMART
FOR MODERN ENGINEERING

Drawing Title :
Wet Areas Ceramic Tiles
Ground Floor

Drawn By.	ENG.Ahmed Yassin	Building Type	Scale		
Approved BY.	ENG.Ahmed Yassin	Town house	Document Type	Shop Drawing	
Drawing No.	SS-CP48-TOWN HOUSE-SD-ARCH-051	Date	May 2026	Floor Level	Ground